CITY OF RICHFIELD

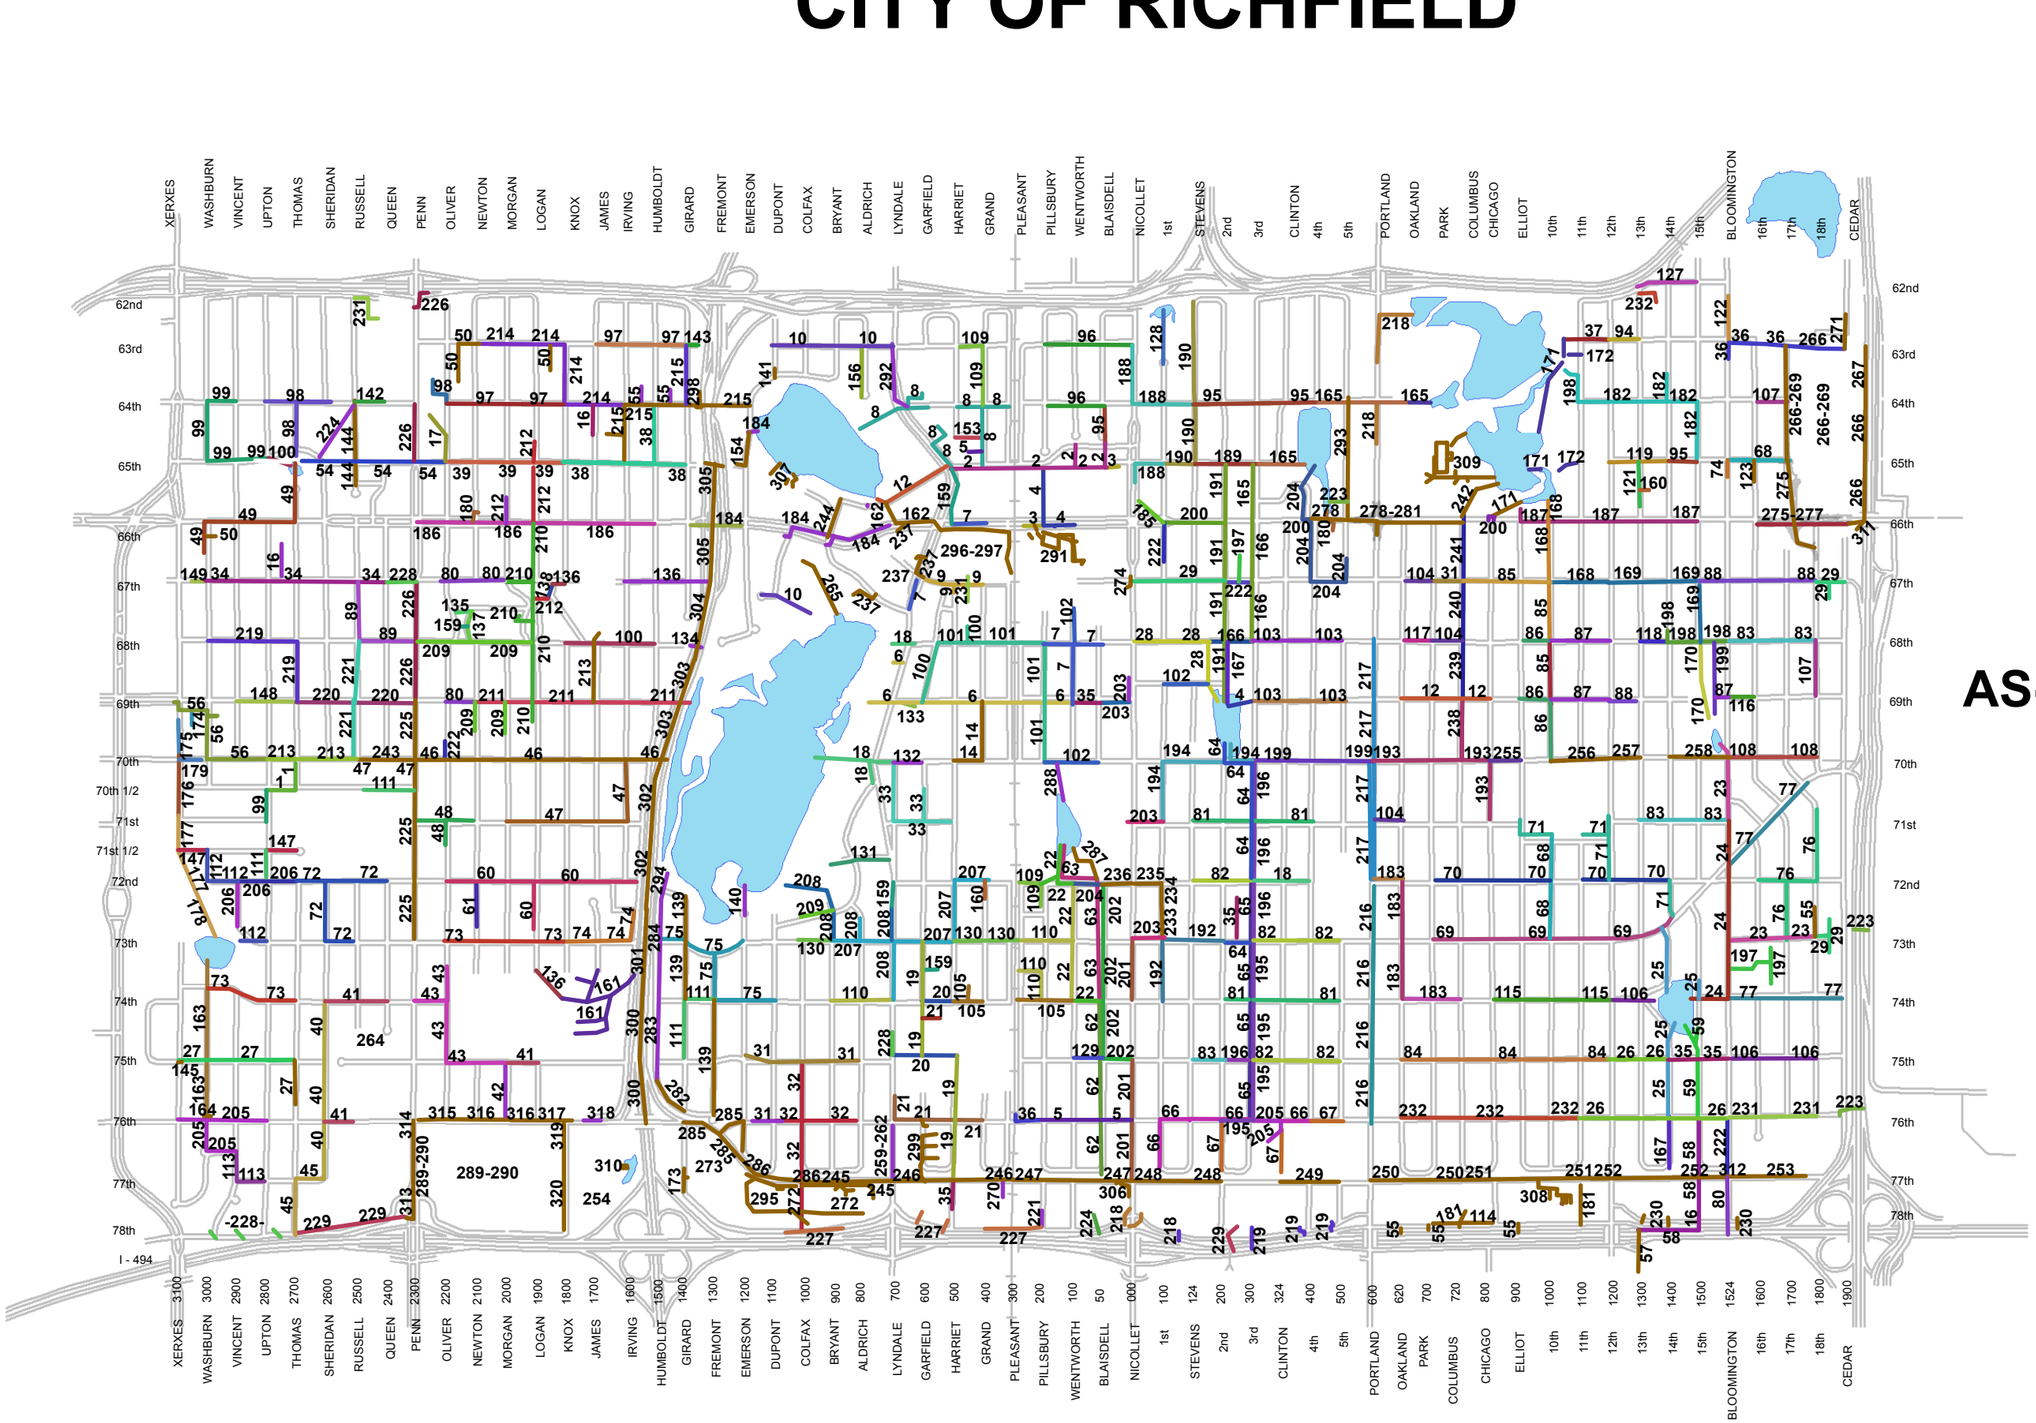

STORM SEWER AS-BUILT INDEX MAP

0 0.125 0.25 0.5 0.75 1 Miles

City of Richfield, Engineering Division 2011