Richfield Sanitary Sewer As-Built Index

Updated: 7/17/2018

0 0.25 0.5 1 Miles

0 600 1,200 2,400 Feet

1 Inch = 600 Feet

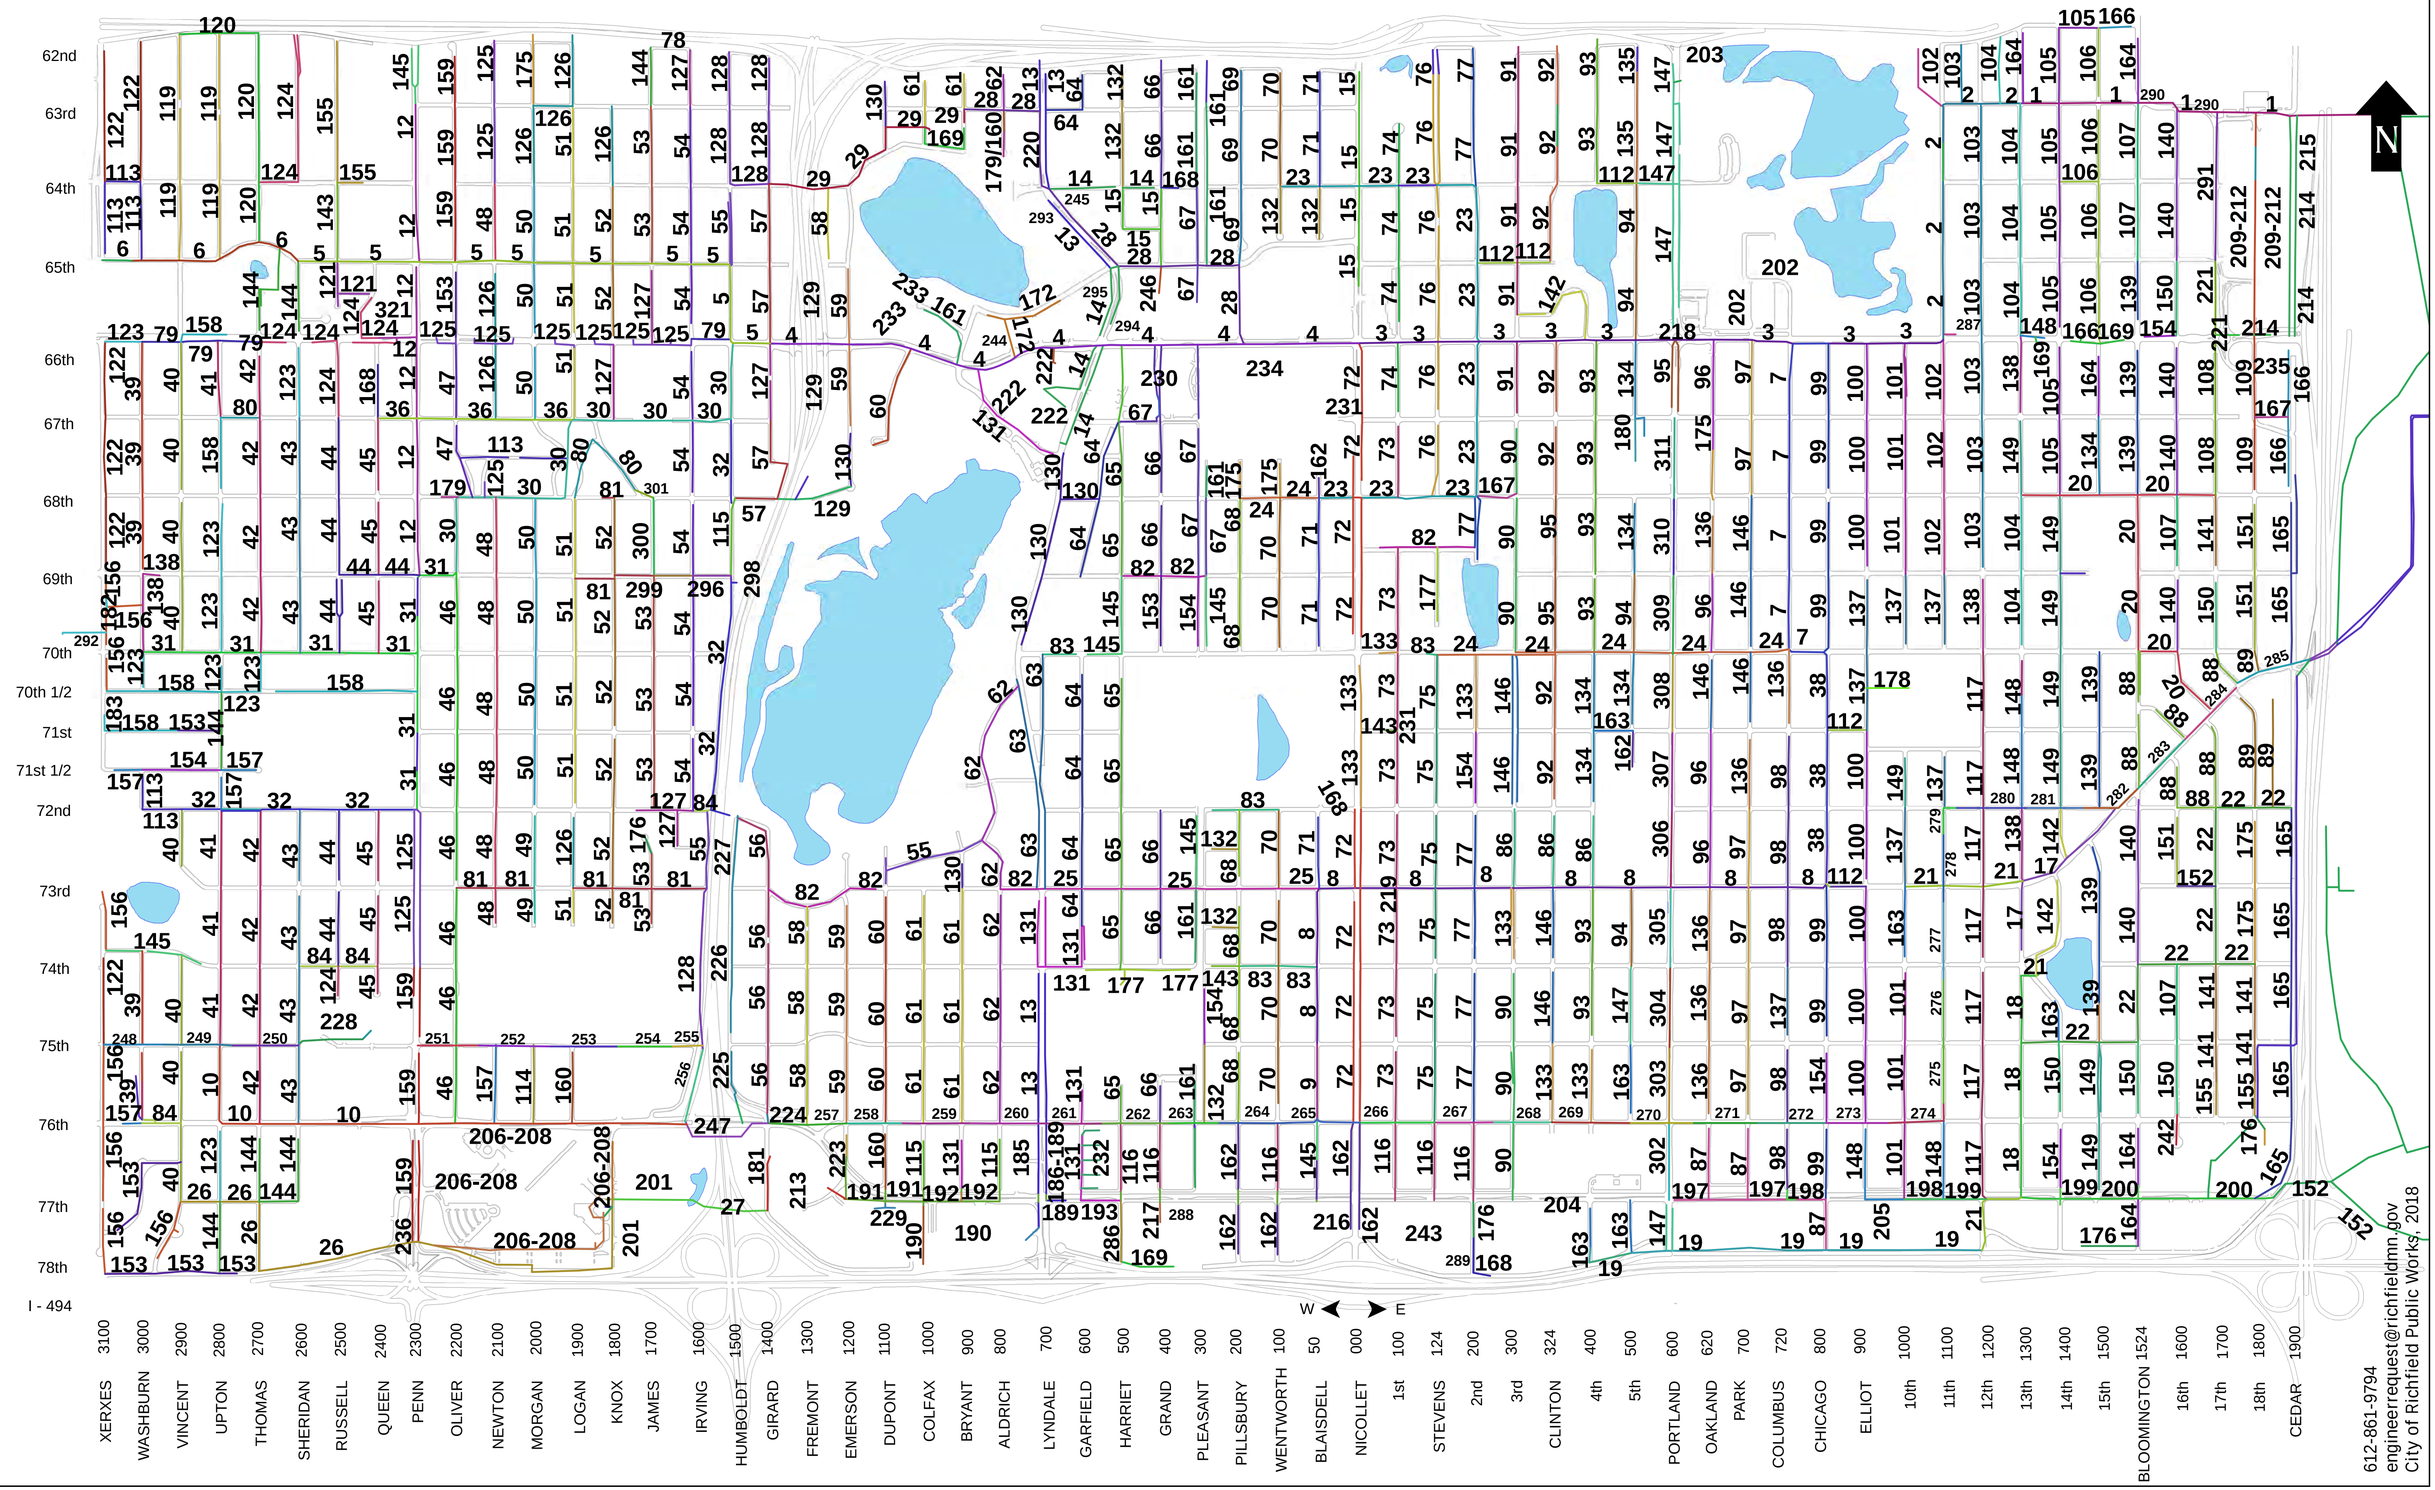

612-861-9794
engineerrequest@richfieldmn.gov
City of Richfield Public Works, 2018